MATCHLINE REFER SHEET 02

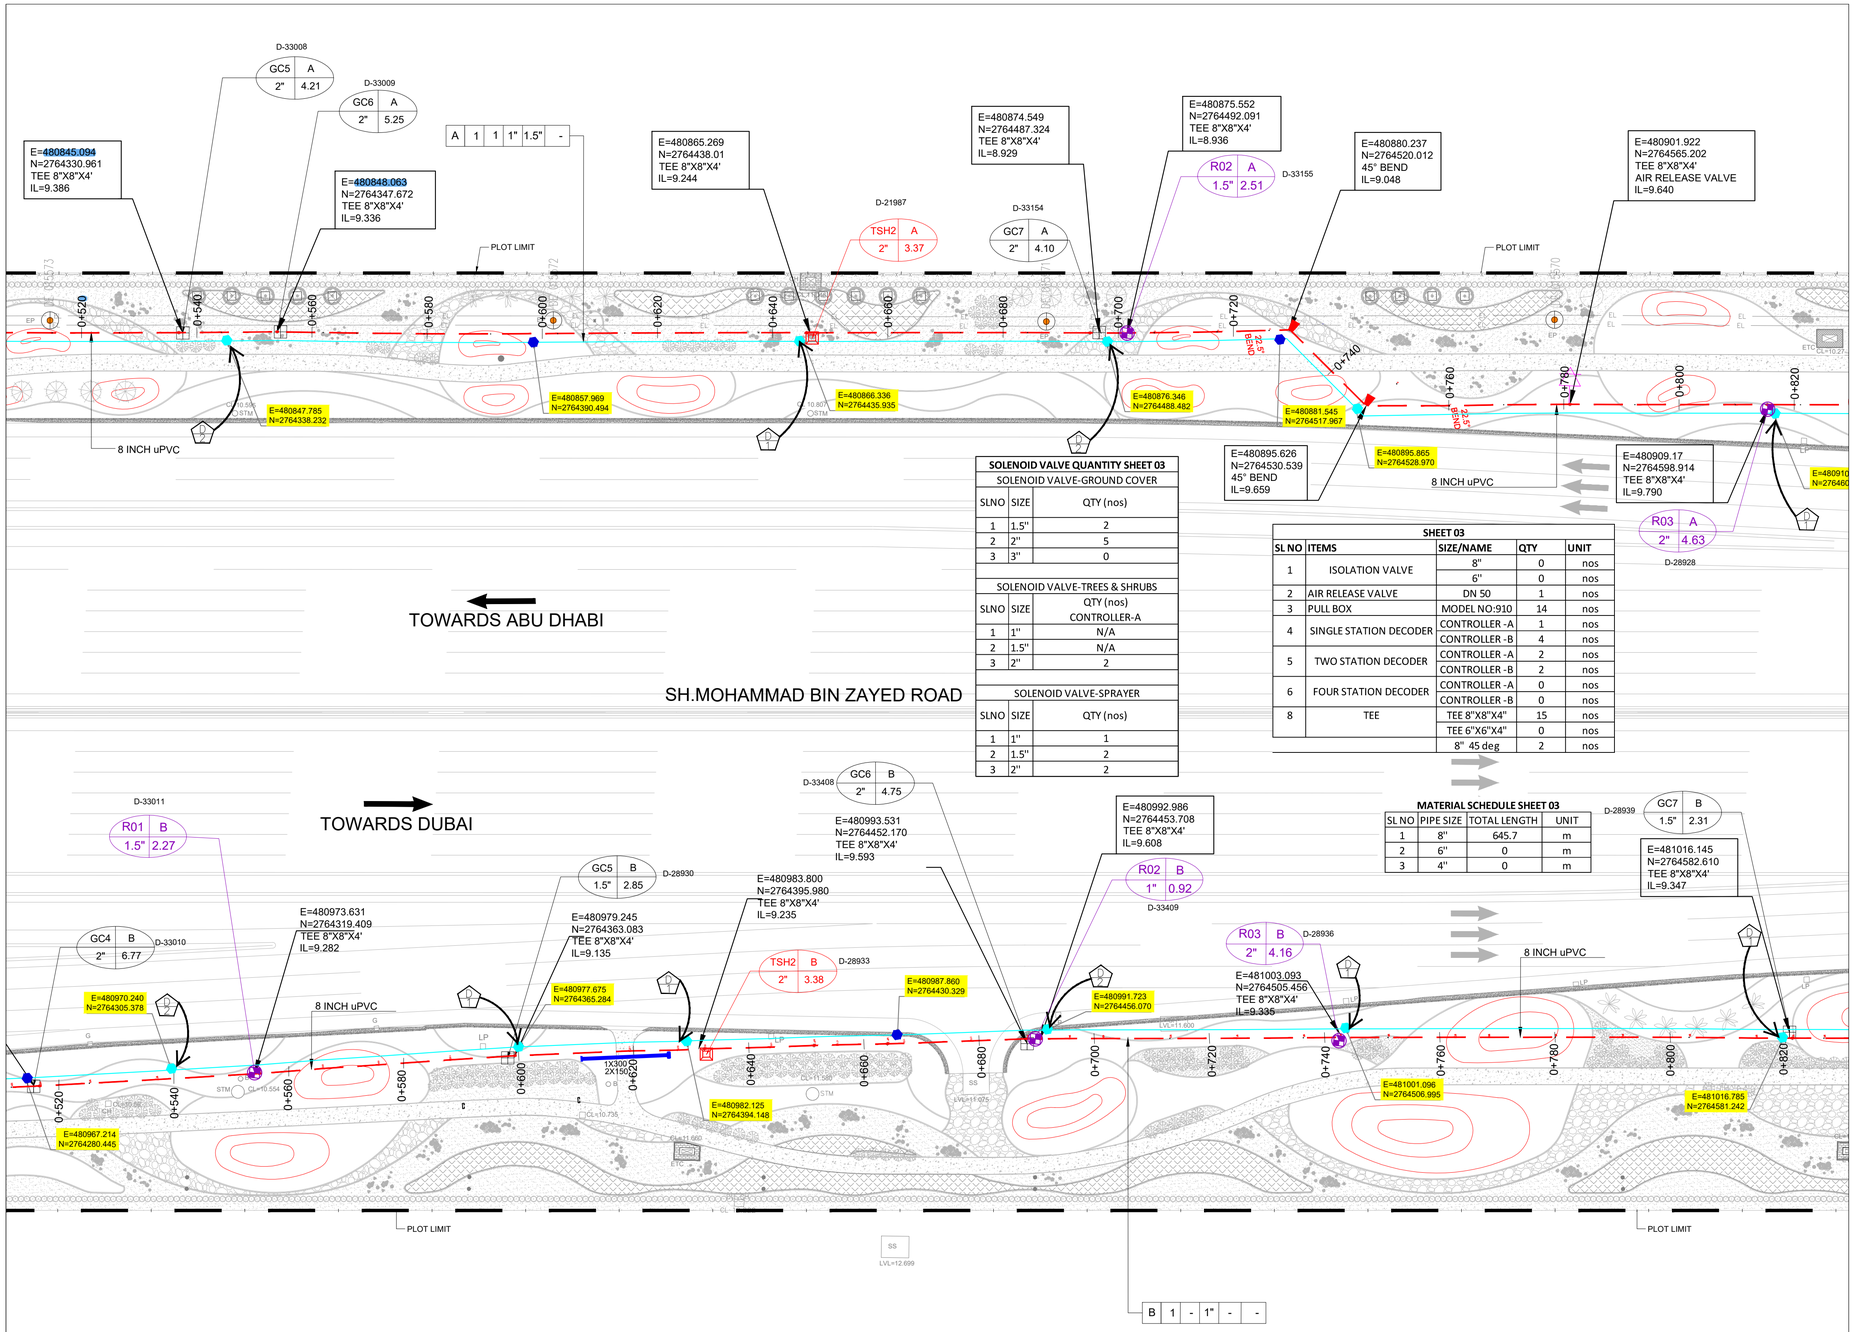

MATCHLINE REFER SHEET 04

SOLENOID VALVE QUANTITY SHEET 03		
SOLENOID VALVE-GROUND COVER		
SLNO	SIZE	QTY (nos)
1	1.5"	2
2	2"	5
3	3"	0
SOLENOID VALVE-TREES & SHRUBS		
SLNO	SIZE	QTY (nos) CONTROLLER-A
1	1"	N/A
2	1.5"	N/A
3	2"	2
SOLENOID VALVE-SPRAYER		
SLNO	SIZE	QTY (nos)
1	1"	1
2	1.5"	2
3	2"	2

SHEET 03				
SL NO	ITEMS	SIZE/NAME	QTY	UNIT
1	ISOLATION VALVE	8"	0	nos
		6"	0	nos
2	AIR RELEASE VALVE	DN 50	1	nos
3	PULL BOX	MODEL NO:910	14	nos
4	SINGLE STATION DECODER	CONTROLLER -A	1	nos
		CONTROLLER -B	4	nos
5	TWO STATION DECODER	CONTROLLER -A	2	nos
		CONTROLLER -B	2	nos
6	FOUR STATION DECODER	CONTROLLER -A	0	nos
		CONTROLLER -B	0	nos
8	TEE	TEE 8"X8"X4"	15	nos
		TEE 6"X6"X4"	0	nos
		8" 45 deg	2	nos

MATERIAL SCHEDULE SHEET 03			
SL NO	PIPE SIZE	TOTAL LENGTH	UNIT
1	8"	645.7	m
2	6"	0	m
3	4"	0	m

CO ORDINATES SOLENOID VALVE FOR GC				
SL NO	VALVE NAME	CONTROLLER NAME	COORDINATES	
			EASTING	NORTHING
1	GC5	A	480845.094	2764330.961
2	GC6	A	480848.063	2764347.672
3	GC7	A	480874.549	2764487.324
4	GC4	B	480968.96	2764282.301
5	GC5	B	480979.106	2764364.336
6	GC6	B	480992.698	2764452.263
7	GC7	B	481017.236	2764582.909

CO ORDINATES (SOLENOID VALVE FOR SHRUBS)				
SL NO	VALVE NAME	CONTROLLER NAME	COORDINATES	
			EASTING	NORTHING
1	TSH2	A	480865.269	2764438.01
2	TSH2	B	480984.139	2764397.555

CO ORDINATES (SOLENOID VALVE FOR MPR ROTATOR SPRAYER)				
SL NO	VALVE NAME	CONTROLLER NAME	COORDINATES	
			EASTING	NORTHING
1	RO2	A	480875.552	2764492.091
2	RO3	A	480909.17	2764598.914
3	RO1	B	480973.918	2764320.204
4	RO2	B	480993.144	2764454.564
5	RO3	B	481002.543	2764505.724

KEY PLAN

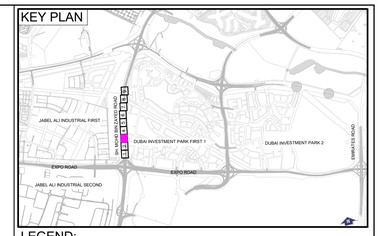

LEGEND:-

- Ø 4 INCH uPVC PIPE CLASS D
- Ø 6 INCH uPVC PIPE CLASS D
- Ø 8 INCH uPVC PIPE CLASS D
- DUCT CROSSING. (OPEN CUT)
- EXISTING DUCT
- uPVC CONDUIT PIPE

TAGS FOR CONDUITS:-
CONTROLLER NAME
IRRIGATION DECODER CABLE
IRRIGATION COMMUNICATION CABLE
CONDUIT SIZE FOR DECODER CABLE
CONDUIT SIZE FOR COMMUNICATION CABLE
POWER CABLE FOR CONTROLLER
A 1 1" P F -

- PULL BOX FOR SURGE PROTECTOR
- PULL BOX.
- ISOLATION VALVE
- IRRIGATION CONTROLLER
- AIR RELEASE VALVE - DN 50
- SINGLE STATION DECODER
- TWO STATION DECODER
- FOUR STATION DECODER
- GC=SOLENOID VALVE FOR GROUND COVER
- TSH=SOLENOID VALVE FOR TREES & SHRUBS
- R=SOLENOID VALVE FOR MP ROTATOR SPRAYER
- THRUST BLOCK

TAGS FOR VALVES:-
D-XXXXX
VALVE TYPE & NO. — SP1 A — CONTROLLER
SIZE OF VALVE (INCH) — 2" 4.50 — FLOW OF THE VALVE IN lps

- · — · — LIMIT OF WORK

NOTES:-
DUCT SCHEDULED
FOR CROSSINGS UNDER ROADS AND FOOTPATHS AS FOLLOWS:-

PIPE SIZE	1"	1-1/2"	2"	3"	4"	6"	8"
DUCT SIZE	2"	3"	4"	6"	8"	12"	12"

REFER TO APPROVED SHOP DRAWING NO IR-73-1-ML-SD-003

AS-BUILT DRAWING

REV.	DATE	DESCRIPTION	APPR'D
03	22-04-21	REVISED AS PER COMMENTS	
02	14-02-21	REVISED AS PER COMMENTS	
01	04-01-21	REVISED AS PER COMMENTS	
00	18-08-20	ISSUED FOR APPROVAL	

Client
بلدية دبي
DUBAI MUNICIPALITY

Consultant
PARSONS

Main contractor :
PROSCAPE
P O BOX:3151. DUBAI, U.A.E.
TEL: 971 4 2770244 FAX : 971 4 2770424. info@proscapegroup.com

Project / Contract
IR 73-1 - IRRIGATION SYSTEM FOR SH. MOHAMMAD BIN ZAYED ROAD TILL ABU DHABI BORDER- PHASE-1 (EXPO 2020)

Drawing Title
AUTOMATIC IRRIGATION MAINLINE LAYOUT PLAN
(SHEET 3 OF 9)

CONTRACT No: IR 73-1		JOB No: PI 3241	
DRAWN	DESIGNED	CHECKED	APPROVED
WP		VG	
SCALE : 1:500 @ A1, 1:1000 @ A3		DATE	ACTUAL SIZE
0 — 25		18-08-20	A1

Drawing No. IR-73-1-ML-AB-003
Rev. 03